

"Client"




Version: V1 Prepared: 01/04/2014
Measured: 28/03/2014

4950 Yonge Street
Toronto, Ontario

Suite 2110

Rentable Area:
1,654 sq ft

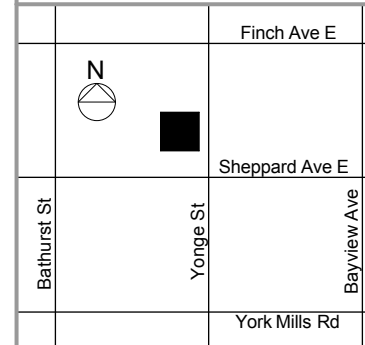

This work product has been prepared by Extreme Measures Inc. pursuant to a contract with the Client for the sole benefit of and use by the Client. No third party may rely on this work product without the receipt of a reliance letter from Extreme Measures Inc.

extreme measures inc. Tel: 416.323.2858
Fax: 416.323.0855
mail@xmeasures.com
www.xmeasures.com